
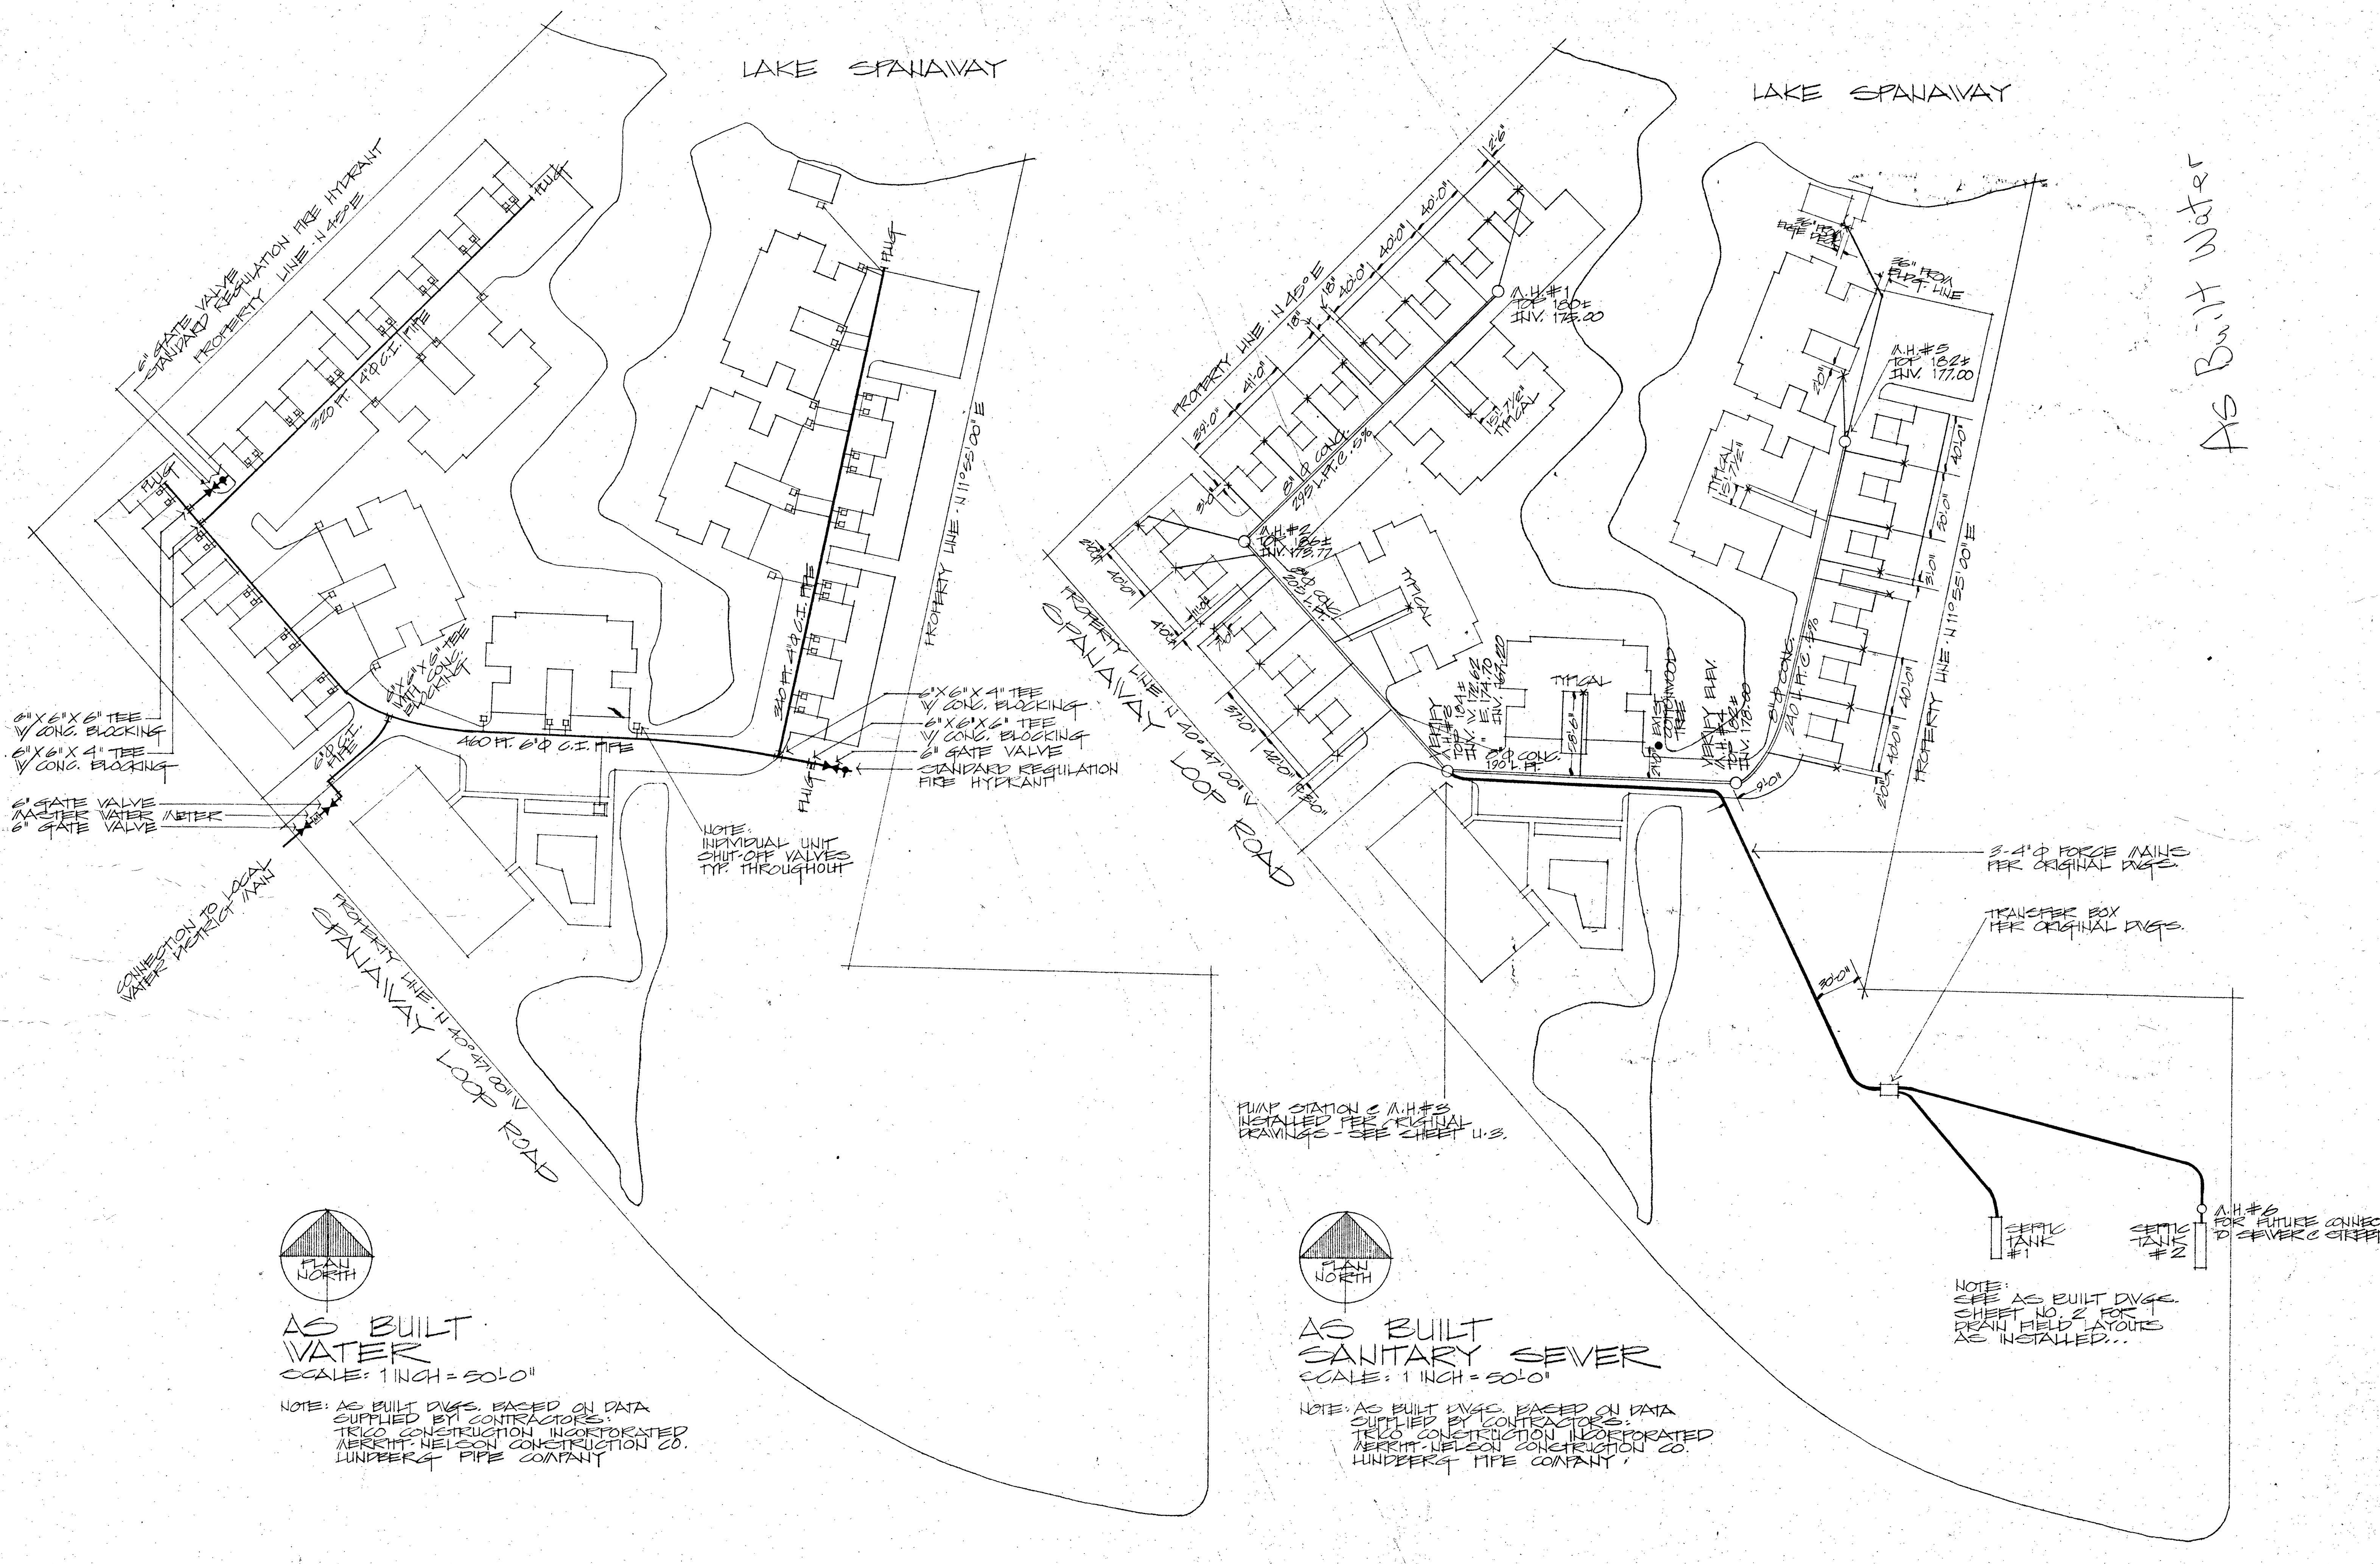


AS BUILT WATER
SCALE: 1 INCH = 50'-0"

NOTE: AS BUILT DVGS. BASED ON DATA SUPPLIED BY CONTRACTORS:
TRICO CONSTRUCTION INCORPORATED
MERRITT NELSON CONSTRUCTION CO.
LUNDBERG PIPE COMPANY

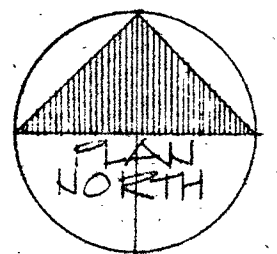

AS BUILT SANITARY SEWER
SCALE: 1 INCH = 50'-0"

NOTE: AS BUILT DVGS. BASED ON DATA SUPPLIED BY CONTRACTORS:
TRICO CONSTRUCTION INCORPORATED
MERRITT NELSON CONSTRUCTION CO.
LUNDBERG PIPE COMPANY

AS BUILT Water

	COFFEE CREEK CONDOMINIUMS		VATER SANITARY SEWER	
	LAKE SPANAWAY, PIERCE COUNTY, WASHINGTON		AS INSTALLED	
RD 2 2990 BAS PERMETER RD SOUTH BOEING FIELD SEATTLE		DRAIN CHECKED DATE 30 MAY 1973 REVISIONS:		
1		OF 2		